



SUITE 01 - APARTAMENTO 01

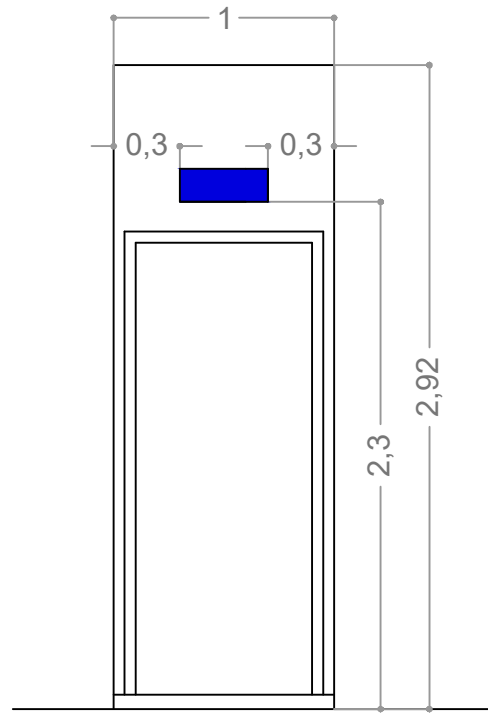

SUITE 02 - APARTAMENTO 01

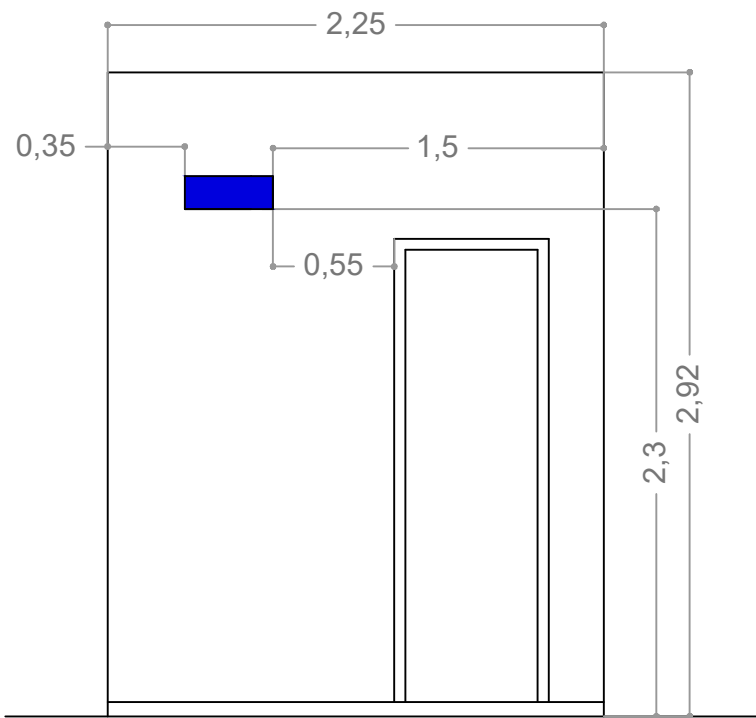

LIVING - APARTAMENTO 01