



SUITE 01 - APARTAMENTO 02

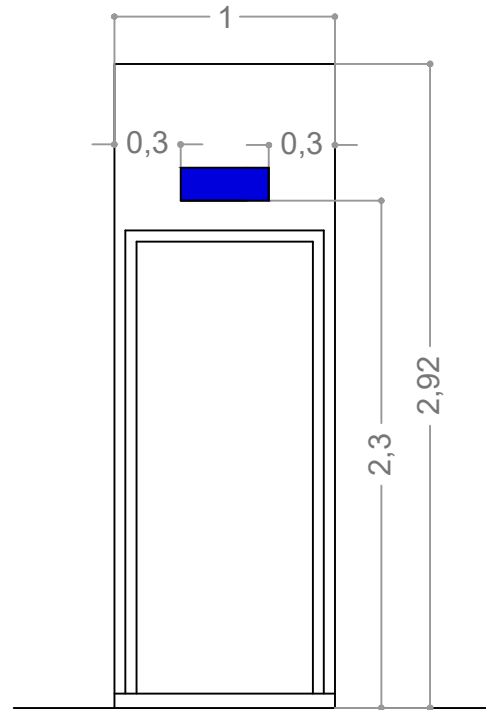

SUITE 02 - APARTAMENTO 02

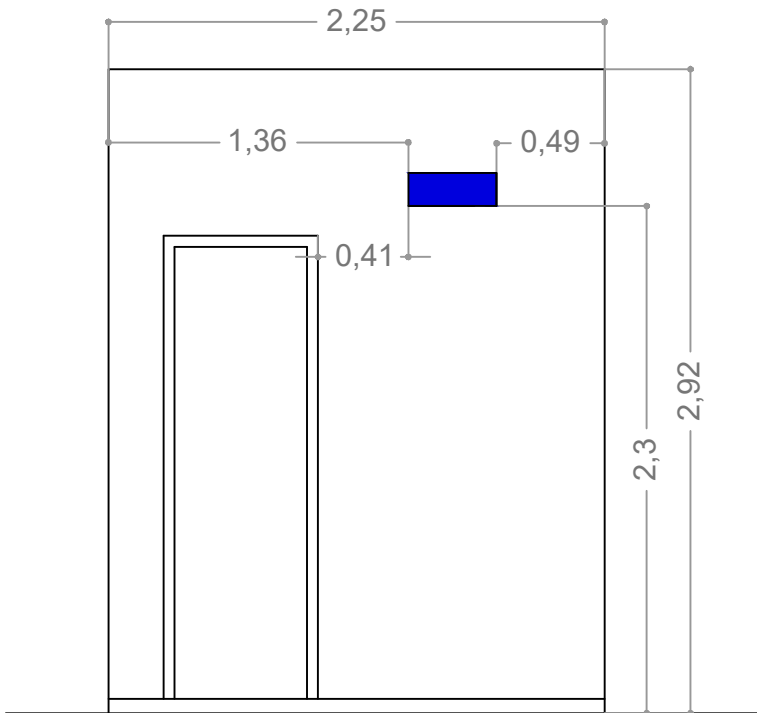

LIVING - APARTAMENTO 02