



SUITE 01 - APARTAMENTO 03

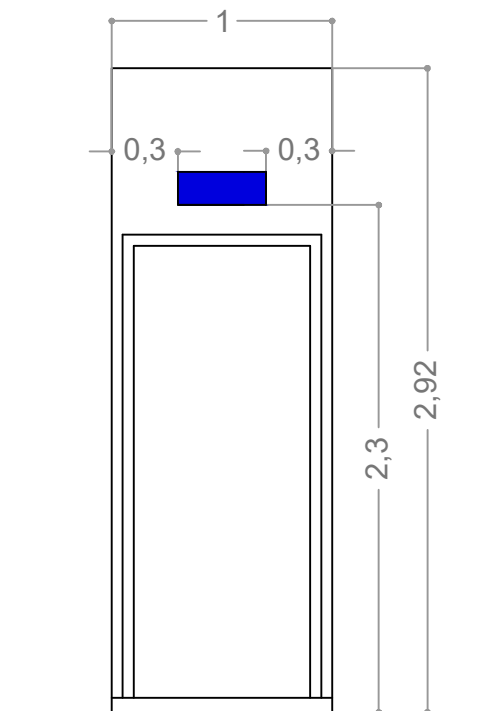

SUITE 02 - APARTAMENTO 03

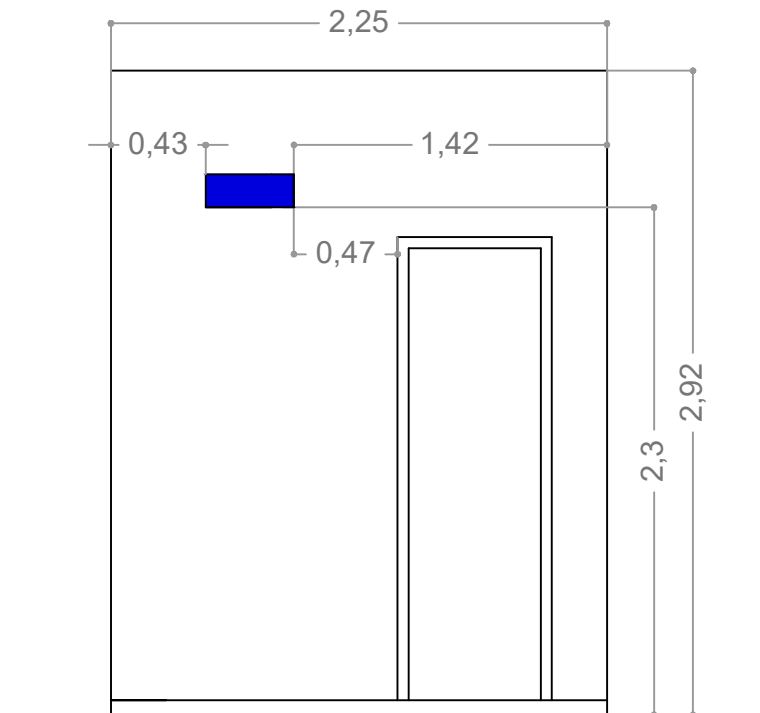

LIVING - APARTAMENTO 03