



SUITE 01 - APARTAMENTO 04

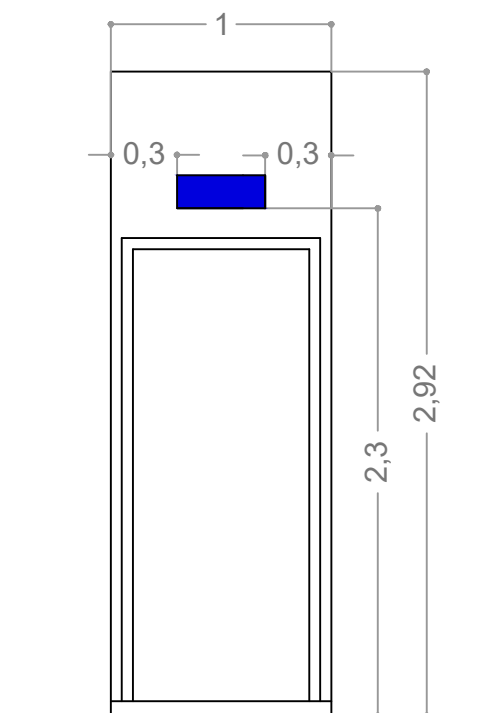

SUITE 02 - APARTAMENTO 04

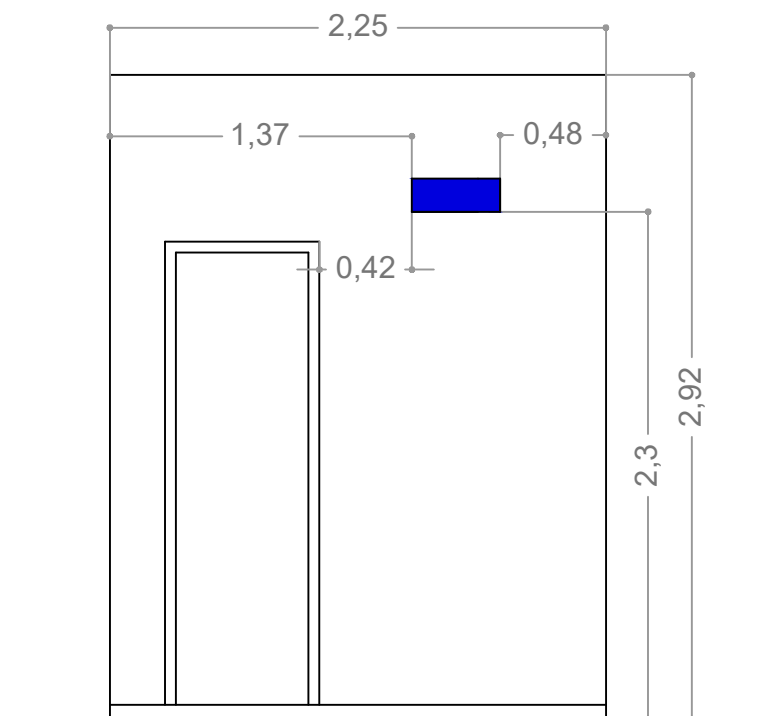

LIVING - APARTAMENTO 04